
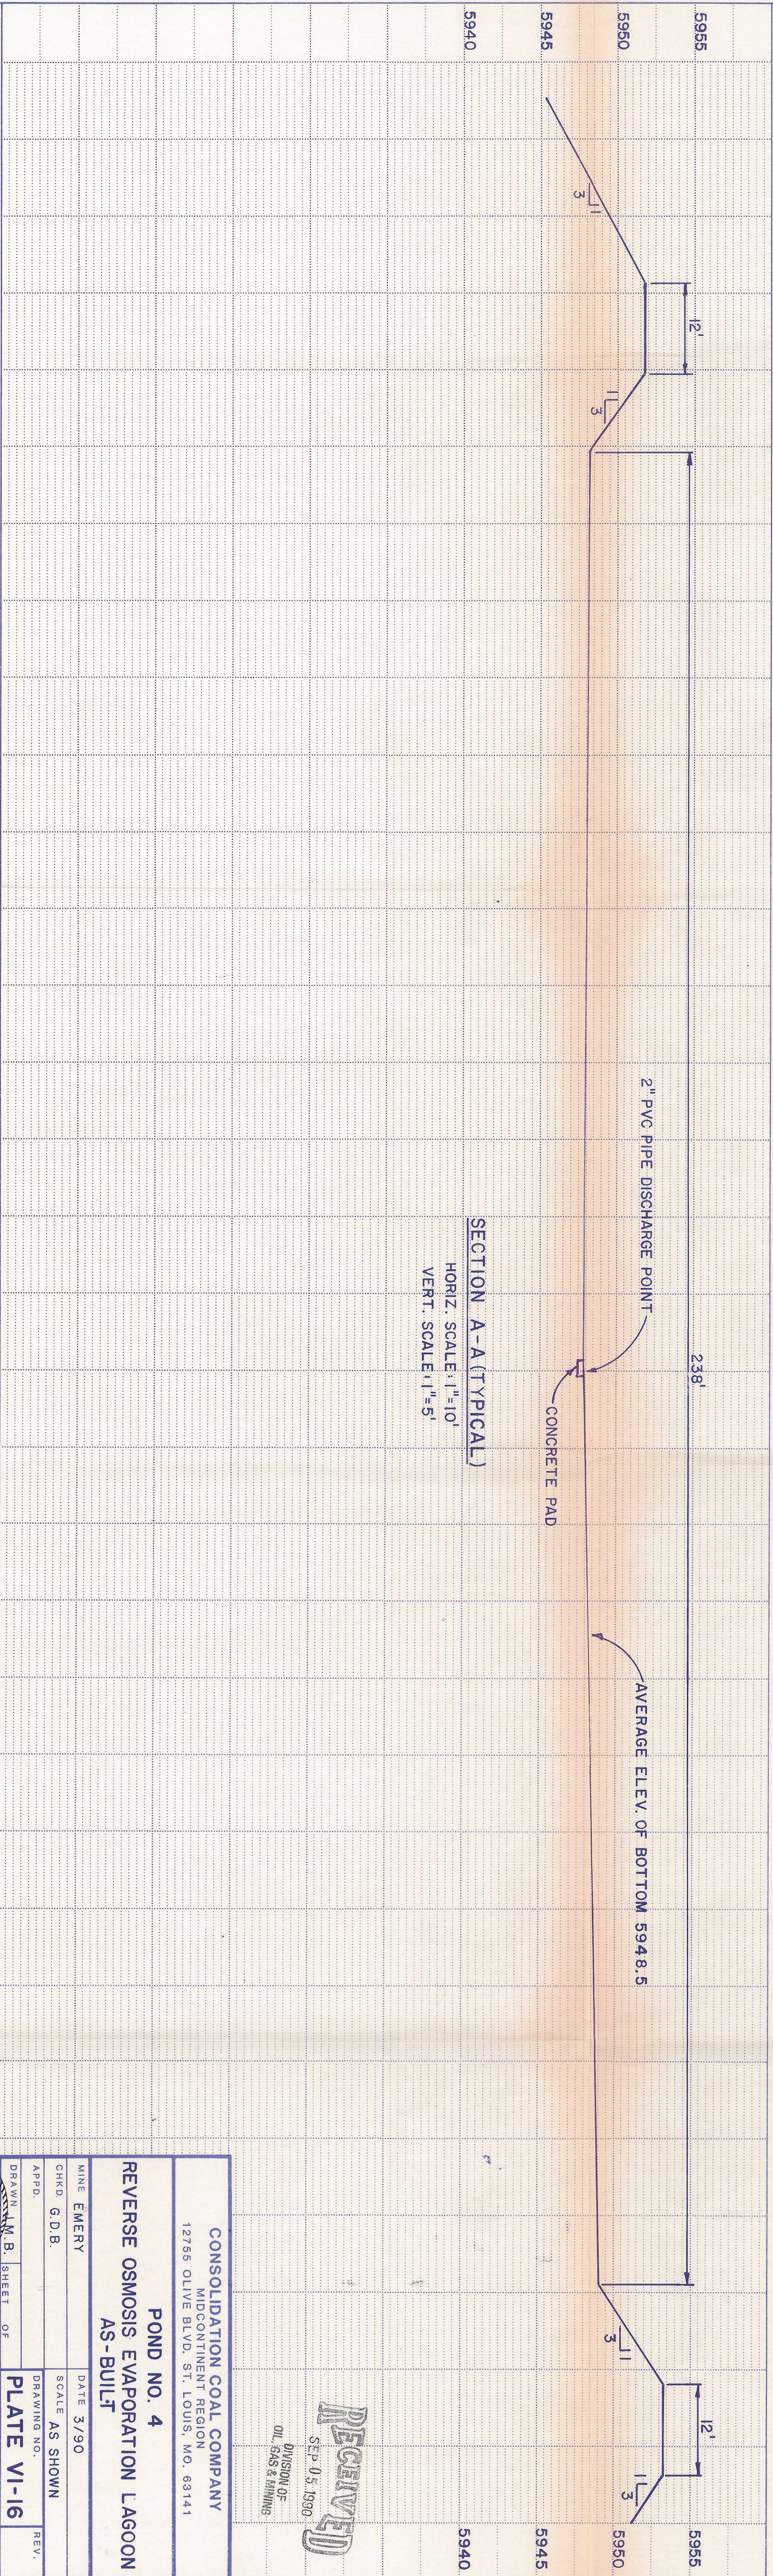


PLAN		BY	DATE
SURVEYED.			
PLOTTED			
ALIGNMENT CHECKED			
RT. OF WAY CHECKED			
NOTE BOOK NO.			

PROFILE		BY	DATE
SURVEYED.			
PLOTTED			
GRADES CHECKED			
B. M.'S NOTED			
STRUCTURE NOTATIONS CHECKED			
NOTE BOOK NO.			

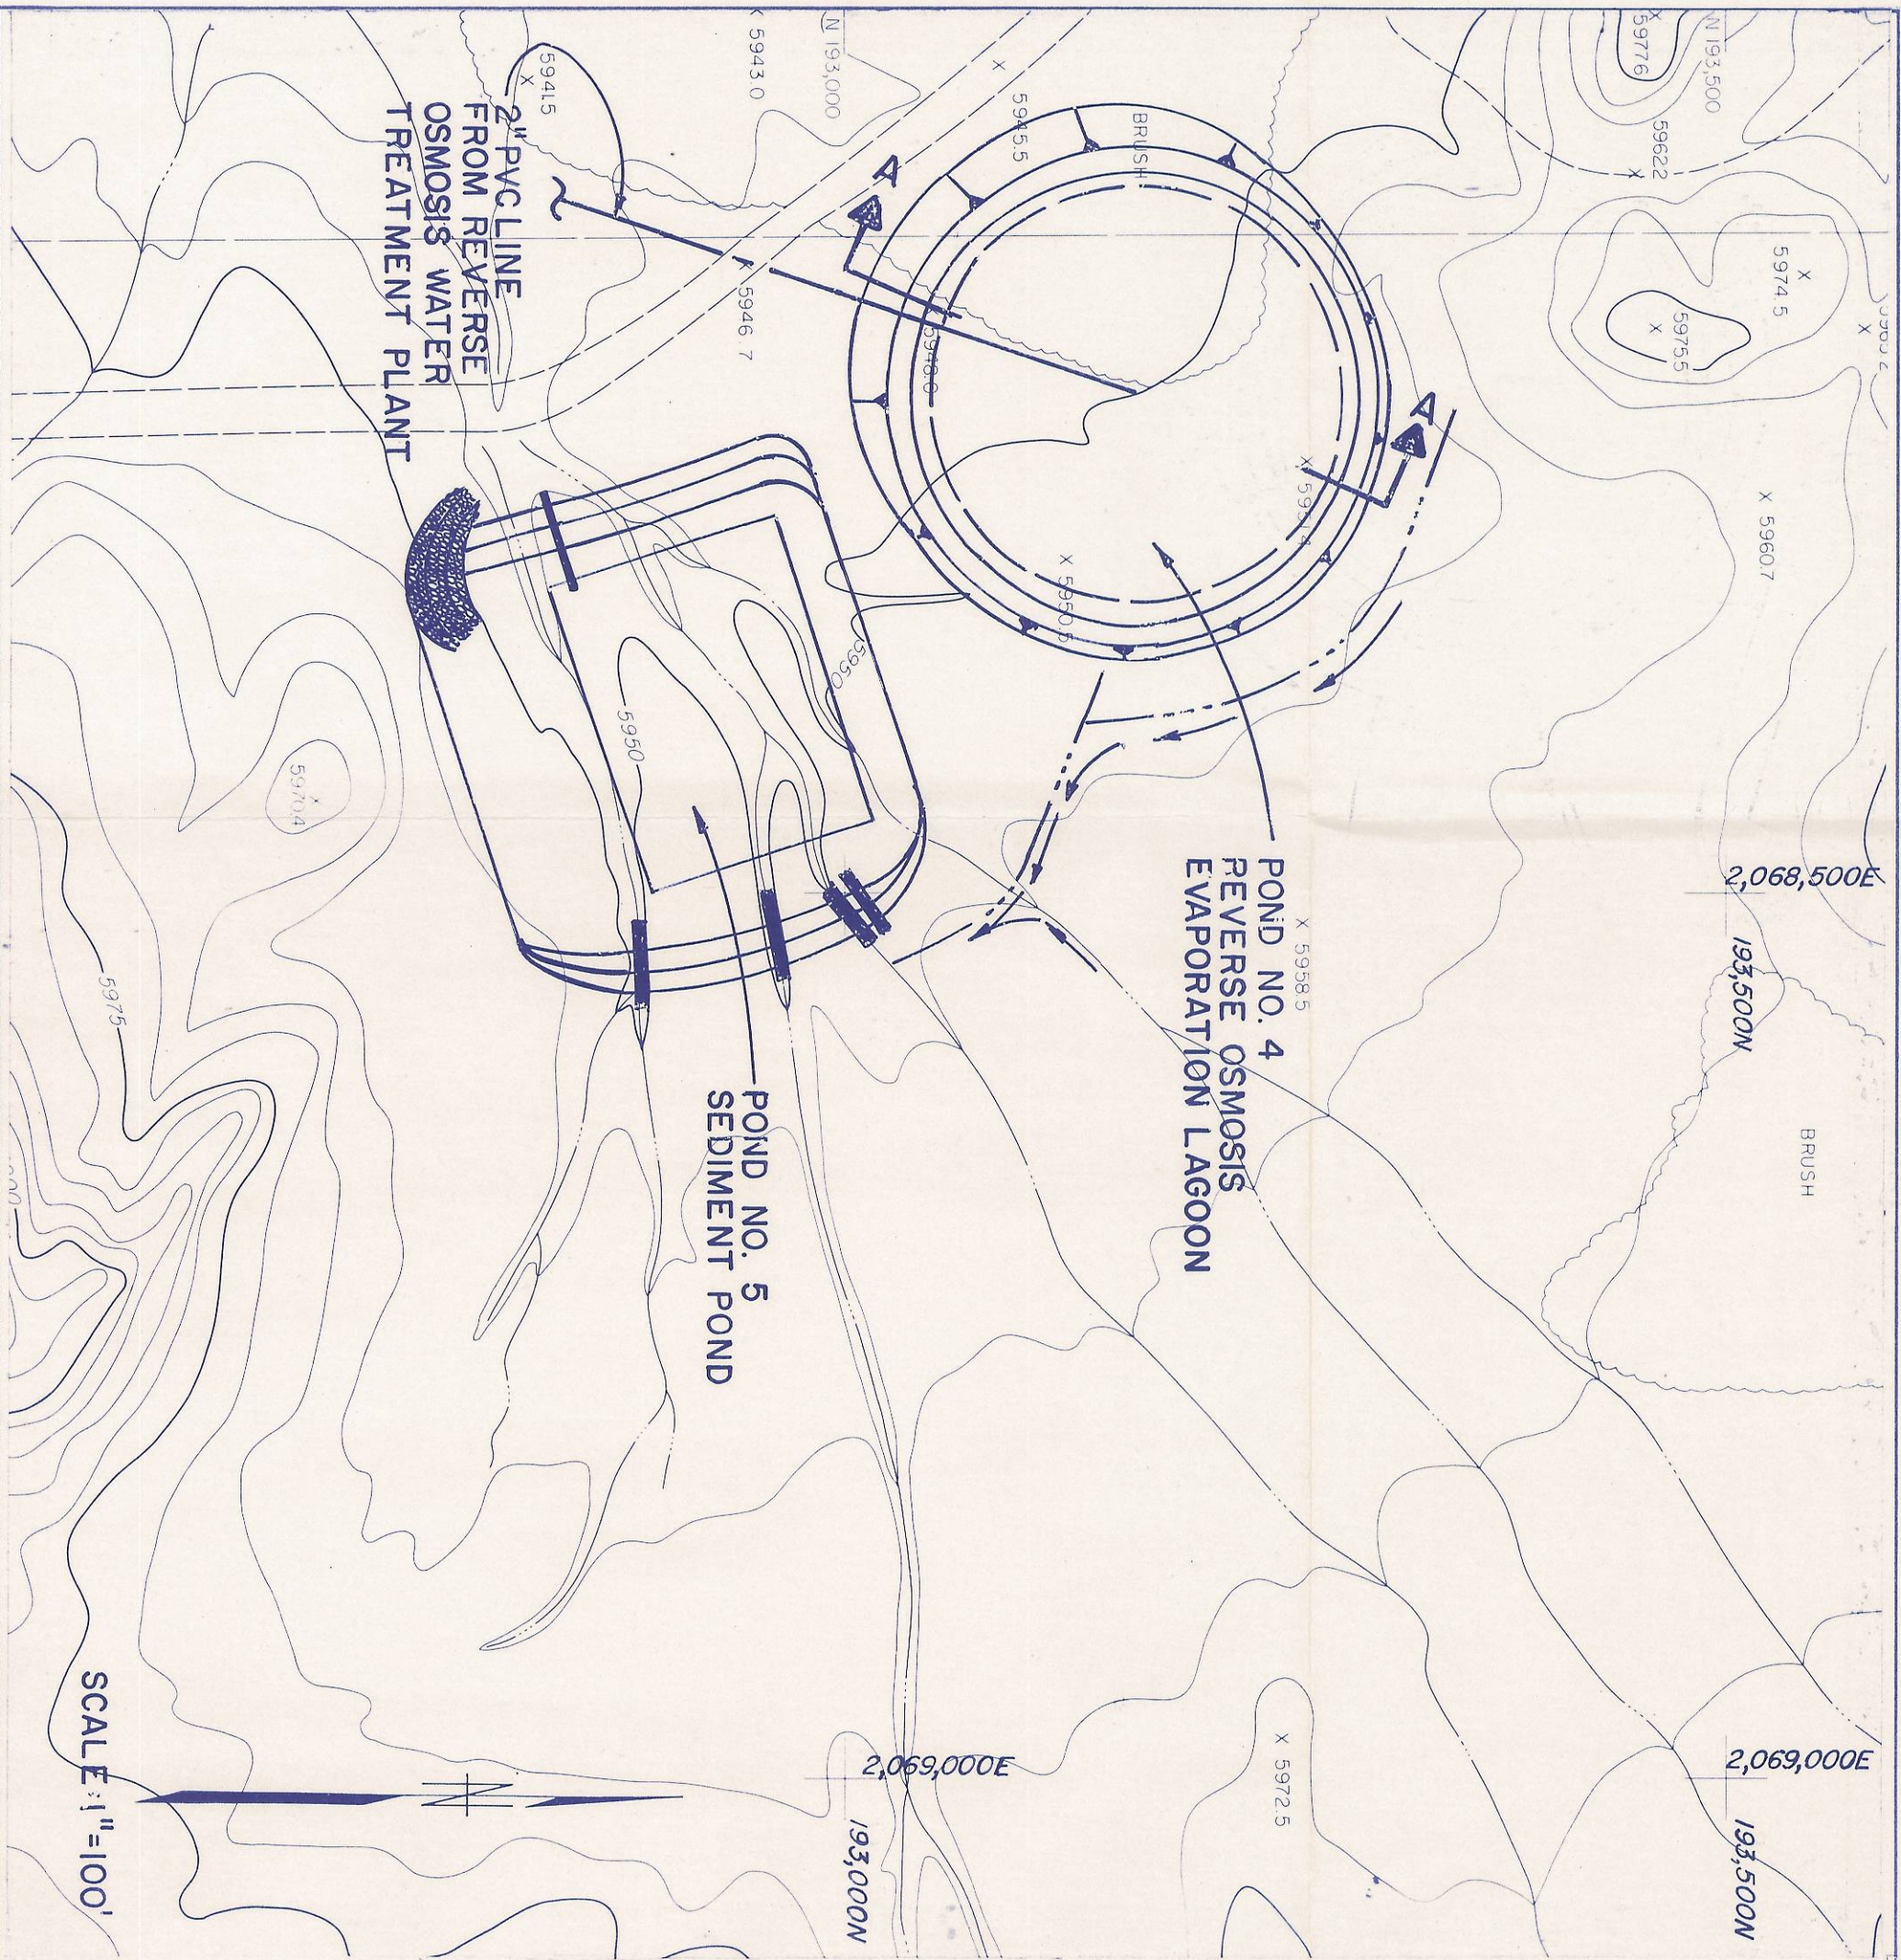

CONSOLIDATION COAL COMPANY
MIDCONTINENT REGION
12755 OLIVE BLVD. ST. LOUIS, MO. 63141

POND NO. 4
REVERSE OSMOSIS EVAPORATION LAGOON
AS-BUILT

MINE EMERY	DATE 3/90
CHKD G.D.B.	SCALE AS SHOWN
APPD.	DRAWING NO.
DRAWN M.B.	SHEET OF
PLATE VI-16	REV.

RECEIVED
SEP 03 1990
DIVISION OF
OIL, GAS & MINING